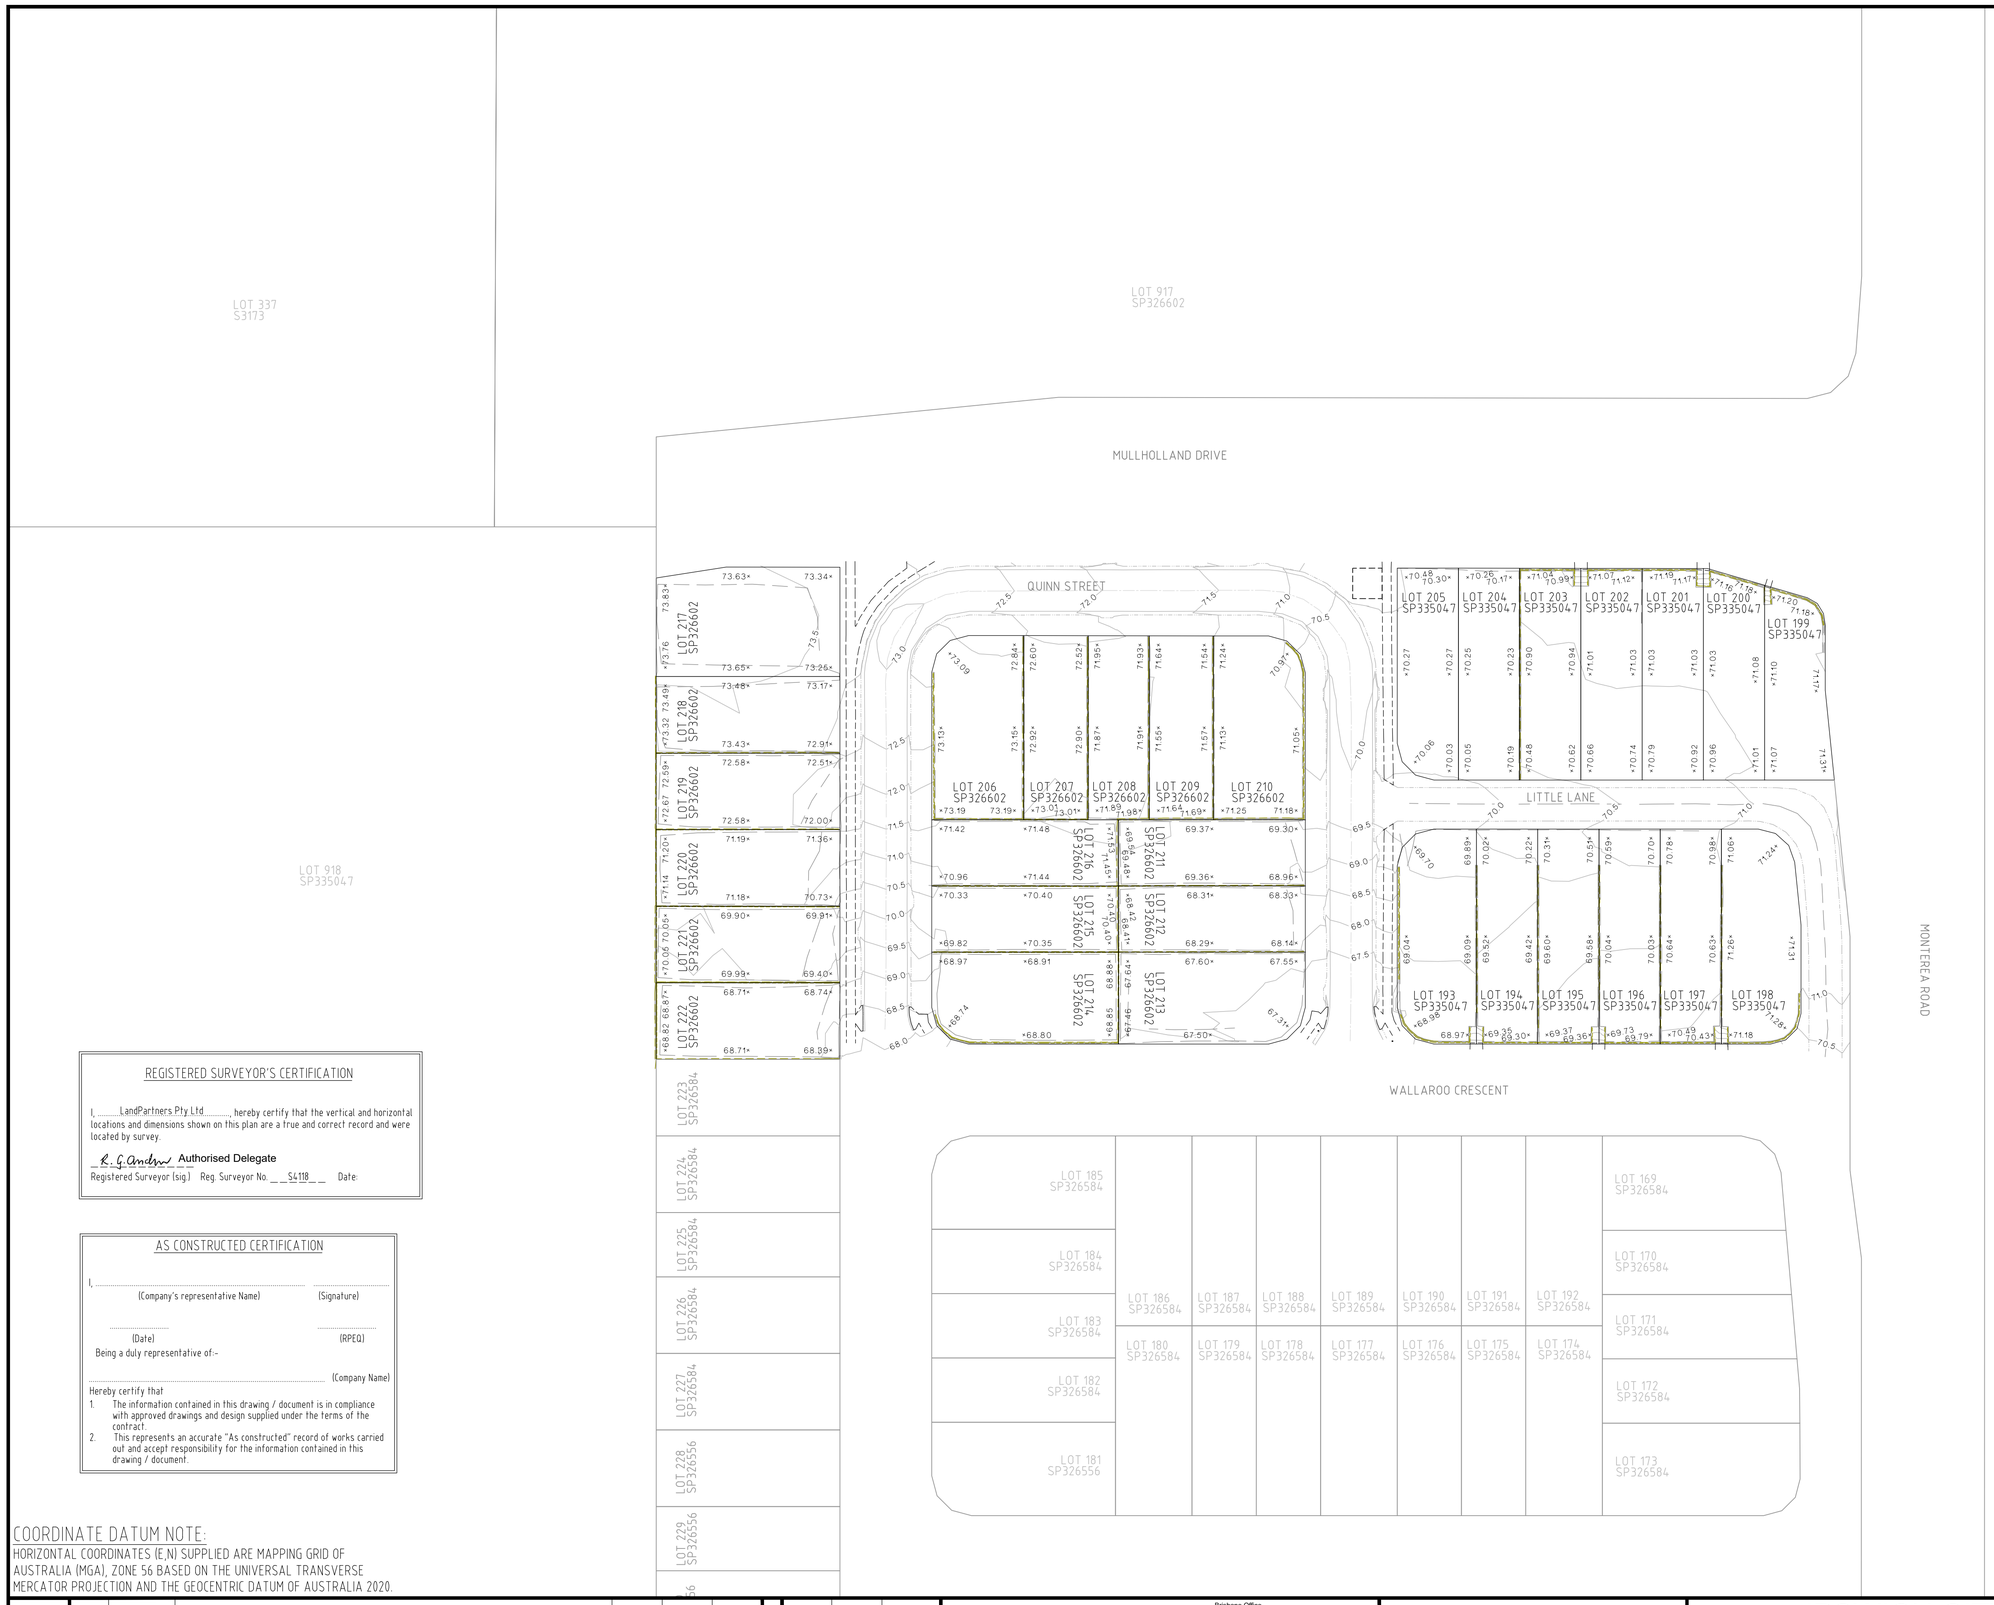

LEGEND

- BOTTOM OF WALL
- TOP OF WALL
- LIP OF KERB
- BACK OF KERB
- EDGE OF CONCRETE
- CONTOURS
- CHANGE OF GRADE
- CROWN OF ROAD
- × STREET SIGN

REGISTERED SURVEYOR'S CERTIFICATION

I, LandPartners Pty Ltd, hereby certify that the vertical and horizontal locations and dimensions shown on this plan are a true and correct record and were located by survey.

R. G. Andrew Authorised Delegate

Registered Surveyor (sig.) Reg. Surveyor No. S4118 Date:

AS CONSTRUCTED CERTIFICATION

I, ... (Company's representative Name) ..... (Signature)

..... (Date) ..... (RPEQ)

Being a duly representative of:-

..... (Company Name)

Hereby certify that

1. The information contained in this drawing / document is in compliance with approved drawings and design supplied under the terms of the contract.
2. This represents an accurate "As constructed" record of works carried out and accept responsibility for the information contained in this drawing / document.

COORDINATE DATUM NOTE:

HORIZONTAL COORDINATES (E,N) SUPPLIED ARE MAPPING GRID OF AUSTRALIA (MGA), ZONE 56 BASED ON THE UNIVERSAL TRANSVERSE MERCATOR PROJECTION AND THE GEOCENTRIC DATUM OF AUSTRALIA 2020.

AS CONSTRUCTED

0 10 20 30 40 50m

SCALE 1:500 @A1

A1

INDEX	DATE	REVISIONS	DRAWN	CHECKED	PASSED
1	15/02/2024	INITIAL ISSUE	MJK	BJB	RA

	INITIALS	DATE
DRAWN	MJK	15/02/2024
CHECKED	BJB	13/02/2024
PASSED	RA	15/02/2024

LANDPARTNERS surveyors and planners
Brisbane Office
Level 1
18 Little Cribb Street
Milton QLD 4064
PO Box 1399
Milton
QLD 4064
p: (07) 3842 1000
f: (07) 3842 1001
e: info@landpartners.com.au
w: www.landpartners.com.au

City of Ipswich

IPSWICH CITY COUNCIL

236-240 MONTEREA RD PRECINCT 2 - STAGES 7 & 7A
AS CONSTRUCTED TOPOGRAPHY
6536/2018/MAPDA/C

SCALE 1:500
SHEET 1 OF 1 SHEETS
DRAWING NO.
BRSS6904-007-72-1